


# CLYDE THOMPSON DRAIN DRAINAGE DISTRICT

SECTIONS 4,5,8,9,16 & 17  
T09N R14W  
RAVENNA TOWNSHIP, MUSKAGON COUNTY

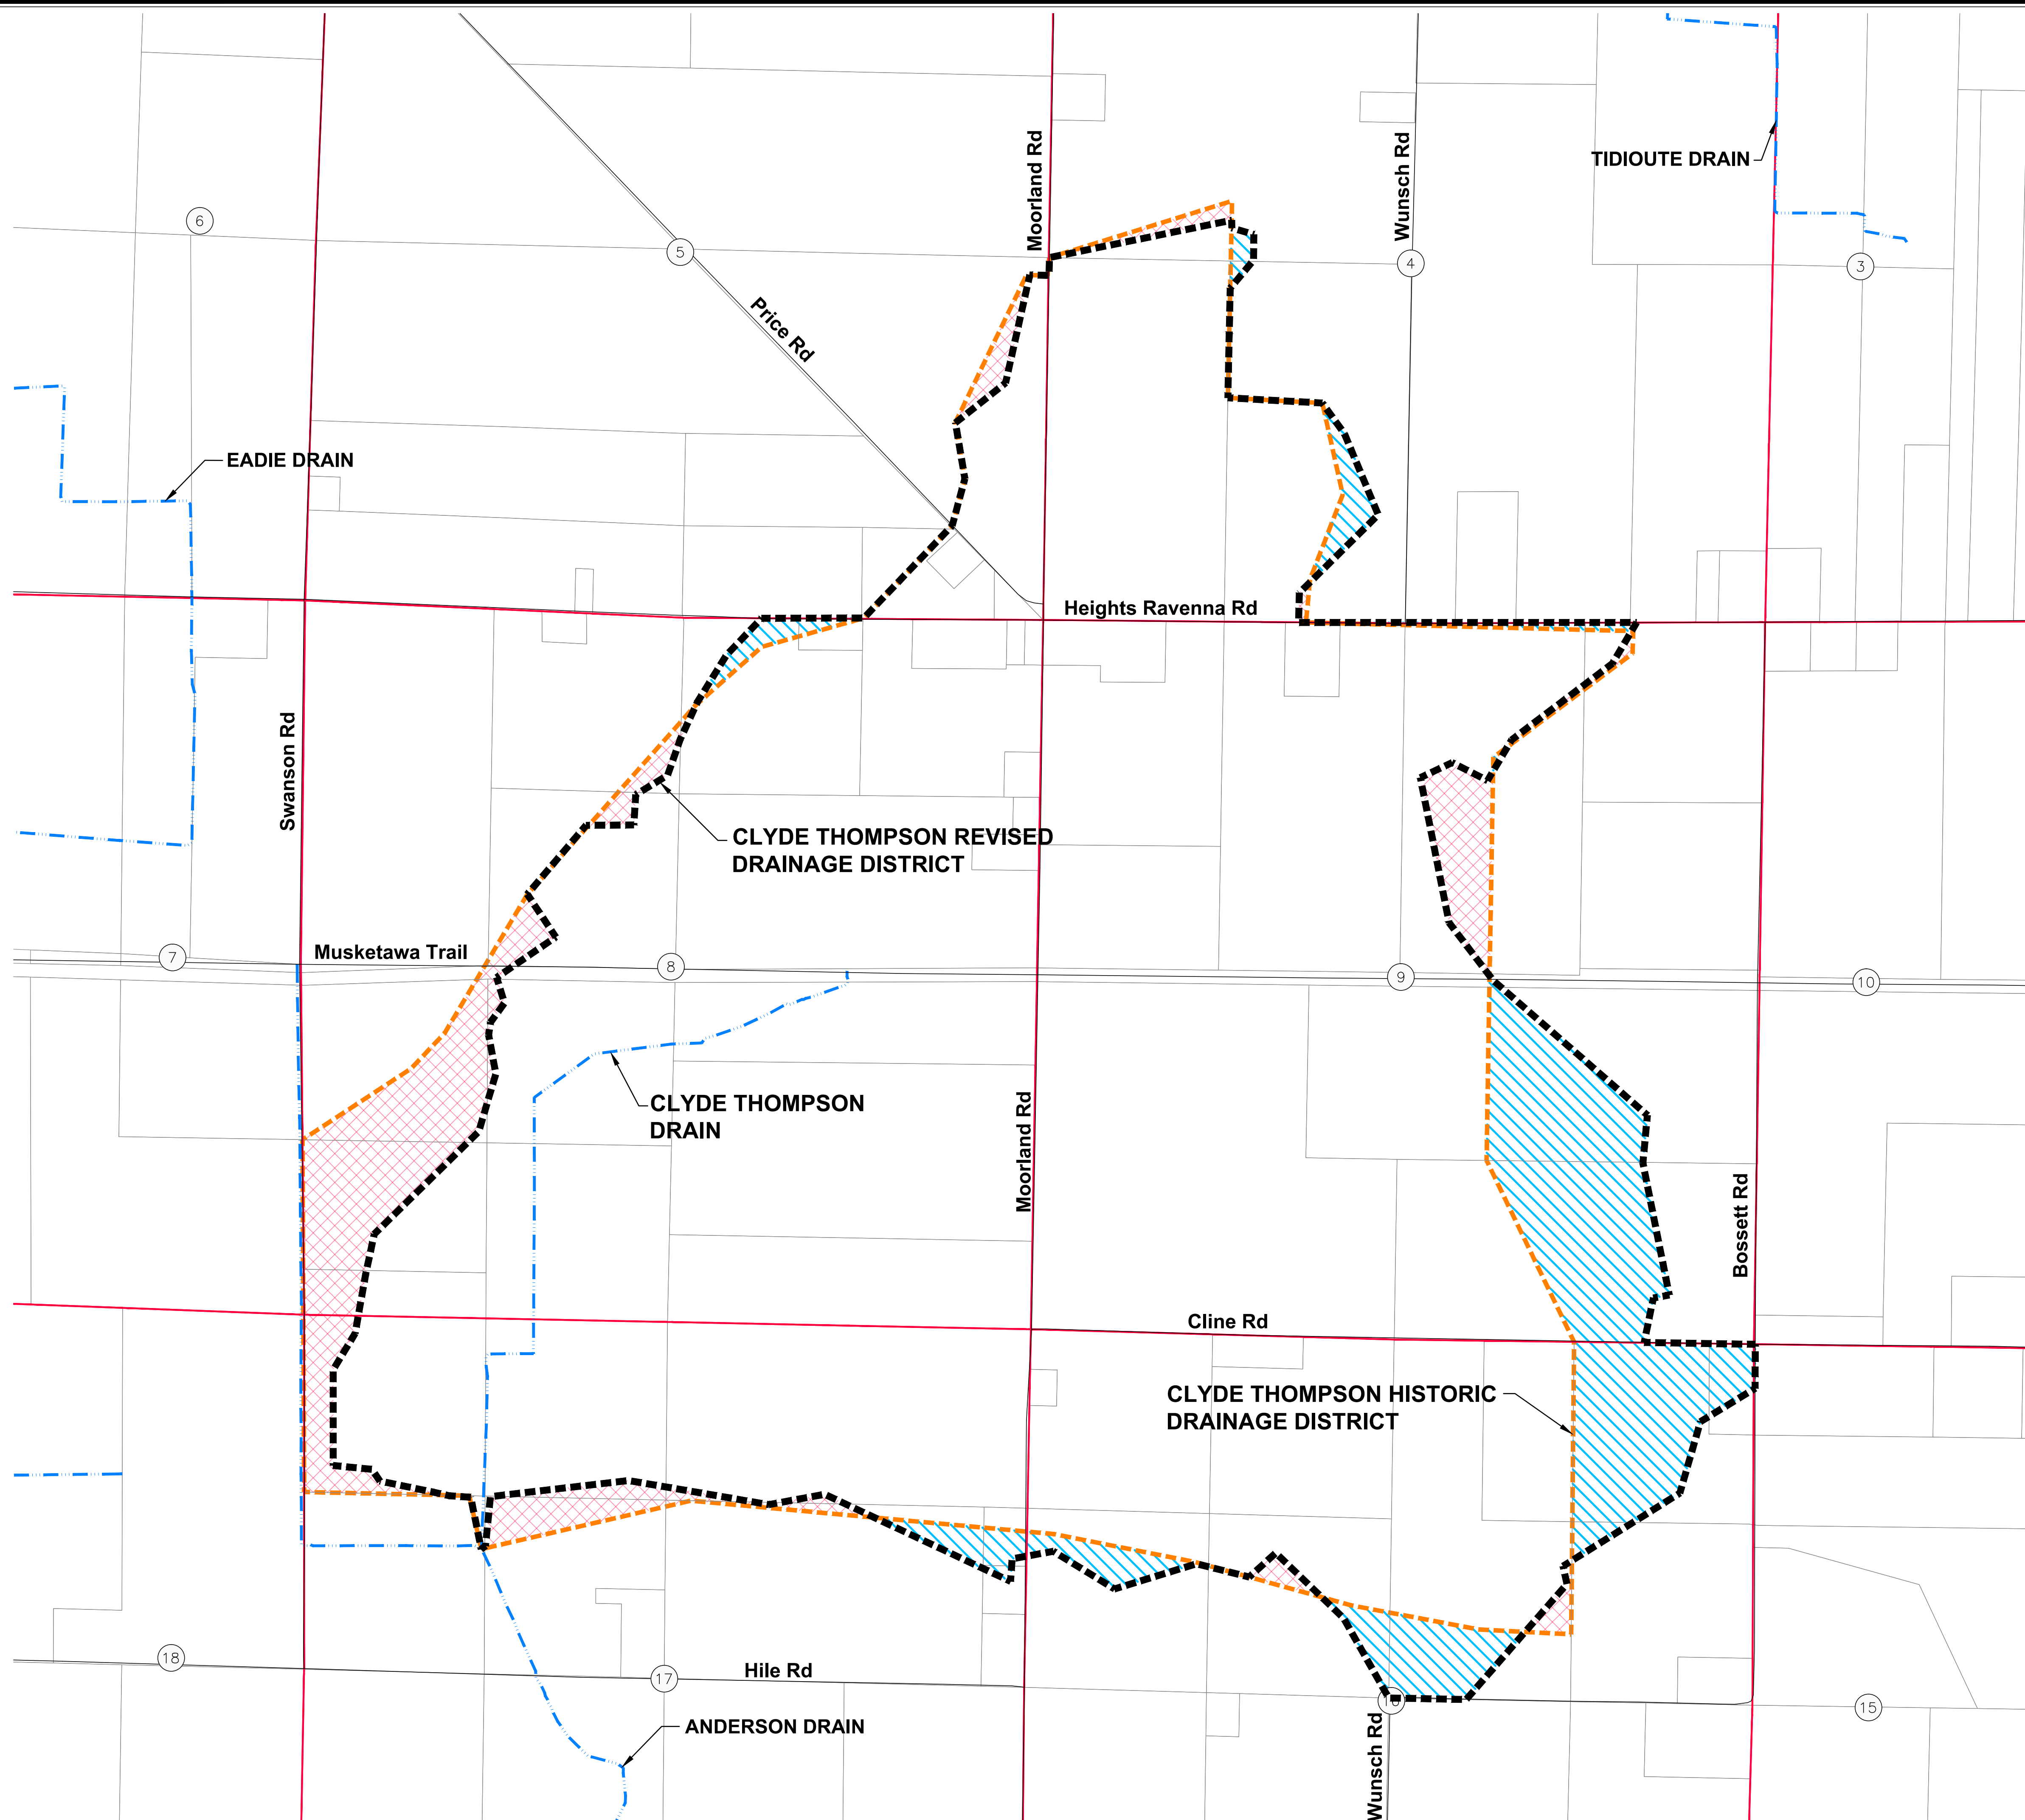


**DRAIN INFORMATION:**

HISTORIC DISTRICT:	1,399.71 ACRES
REVISED DISTRICT:	1,430.22 ACRES
LANDS ADDED:	116.86 ACRES
LANDS REMOVED:	86.35 ACRES
<b>DRAIN LENGTH:</b>	1.19 MILES

**LEGEND**

- [Red Cross-hatch] LANDS REMOVED
- [Blue Diagonal Hatch] LANDS ADDED
- [Blue Dashed Line] DRAIN
- [Orange Dashed Line] HISTORIC DRAINAGE DISTRICT BOUNDARY
- [Black Dashed Line] REVISED DRAINAGE DISTRICT BOUNDARY
- [Thin Grey Line] PARCEL LINES
- [Red Line] SECTION LINES
- [Thin Grey Line] COUNTY LINE
- [Grey Dashed Line] TOWNSHIP LINE
- [Circle with #] SECTION NUMBERS

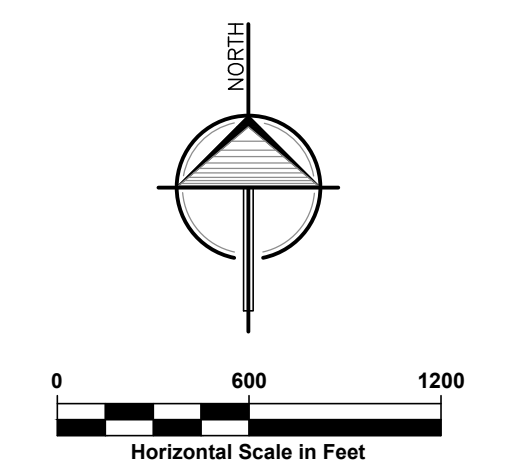

## LANDS ADDED/REMOVED MAP EXHIBIT B-1

	3800 W. River Dr. Ste. A Comstock Park MI 49321 ph. 616.301.7888 fax. 616.784.0737 www.LREmi.com	PROJECT#: 17-085.05
		DRAWN BY: NDJ
		DATE: 3/2019
	QA/QC: AWS	

10/13/17 2017 - 18.dwg 11/13/2018 Clyde Thompson Drain 17-085.05 Exhibit B-1 and B-2 - Clyde Thompson, 2017